


measure success

INDEXING INFORMATION	
	<u> </u> <u>NW</u> ⁴ <u> </u> <u>NE</u> ⁴ SECTION: <u>22</u> TOWNSHIP: <u>24N</u> RANGE: <u>04E, W.M.</u> COUNTY: <u>KING</u>

	BRASS DISC (FOUND)
	CENTERLINE ROW
	CONCRETE SURFACE
	RETAINING WALL
	FENCE LINE (CHAIN LINK)
	FENCE LINE (WOOD)
	GAS LINE
	INLET (TYPE 1)
	LP ○ LIGHT POLE
	NAIL AS NOTED
	MONUMENT IN CASE (FOUND)
	POWER SURFACE
	POWER (UNDERGROUND)
	POWER VAULT
	REBAR AS NOTED (FOUND)
	REBAR & CAP (SET)
	SS ○ SEWER LINE
	SEWER MANHOLE
	SIGN (AS NOTED)
	SD → STORM DRAIN LINE
	SLH ○ STREET LIGHT HAND HOLE
	UT → UNDERGROUND TELEPHONE
	W LINE WATER LINE
	BLDG. BUILDING
	CALCUTT. CALCULATED
	COS CITY OF SEATTLE
	CONC. CONCRETE
	CORNER
	G GAS
	LS.# LAND SURVEYOR NUMBER
	MEAS. MEASURED
	MON. MONUMENT
	PROP. PROPERTY
	REC. DATA RECORD DATA
	REC. OF SURVEY RECORD OF SURVEY
	SD SERVICE DRAIN
	SSMH ○ SANITARY SEWER MANHOLE
	SS SANITARY SIDE SEWER
	SF SQUARE FOOT
	REC. NO. 20909720000113

VICINITY MAP
N.T.S.

[illegible]

SIGNIFICANT OBSERVATIONS





Terrane


10801 Main Street, Suite 102, Bellevue, WA 98004
 phone 425.458.4488 support@terrane.net
www.terrane.net

JOB NUMBER:	210407
DATE:	06/18/21
DRAFTED BY:	JKK
CHECKED BY:	SRM
SCALE:	N T S
REVISION HISTORY	
SHEET NUMBER	
1 OF 2	


ALTA/NSPS LAND TITLE SURVEY

LEGEND

- ⊕ BRASS DISC (FOUND)
- CENTERLINE ROW
- CONCRETE SURFACE
- RETAINING WALL
- FENCE LINE (CHAIN LINK)
- FENCE LINE (WOOD)
- GAS LINE
- INLET (TYPE 1)
- LIGHT POLE
- ⊗ NAIL AS NOTED
- ⊗ MONUMENT IN CASE (FOUND)
- PAVER SURFACE
- POWER (UNDERGROUND)
- POWER VAULT
- ⊗ REBAR AS NOTED (FOUND)
- ⊗ REBAR & CAP (SET)
- SS SEWER LINE
- SEWER MANHOLE
- SIGN (AS NOTED)
- SD STORM DRAIN LINE
- SLH STREET LIGHT HAND HOLE
- UT UNDERGROUND TELEPHONE
- W WATER LINE
- BLDG BUILDING
- CALC'D CALCULATED
- COS CITY OF SEATTLE
- CONC CONCRETE
- COR CORNER
- G GAS
- LS# LAND SURVEYOR NUMBER
- MEAS MEASURED
- MON MONUMENT
- PROP PROPERTY
- (R) RECORD DATA
- ROS RECORD OF SURVEY
- SD SERVICE DRAIN
- SSMH SANITARY SEWER MANHOLE
- SSS SANITARY SIDE SEWER
- SF SQUARE FEET
- REC. NO. 20090720000113

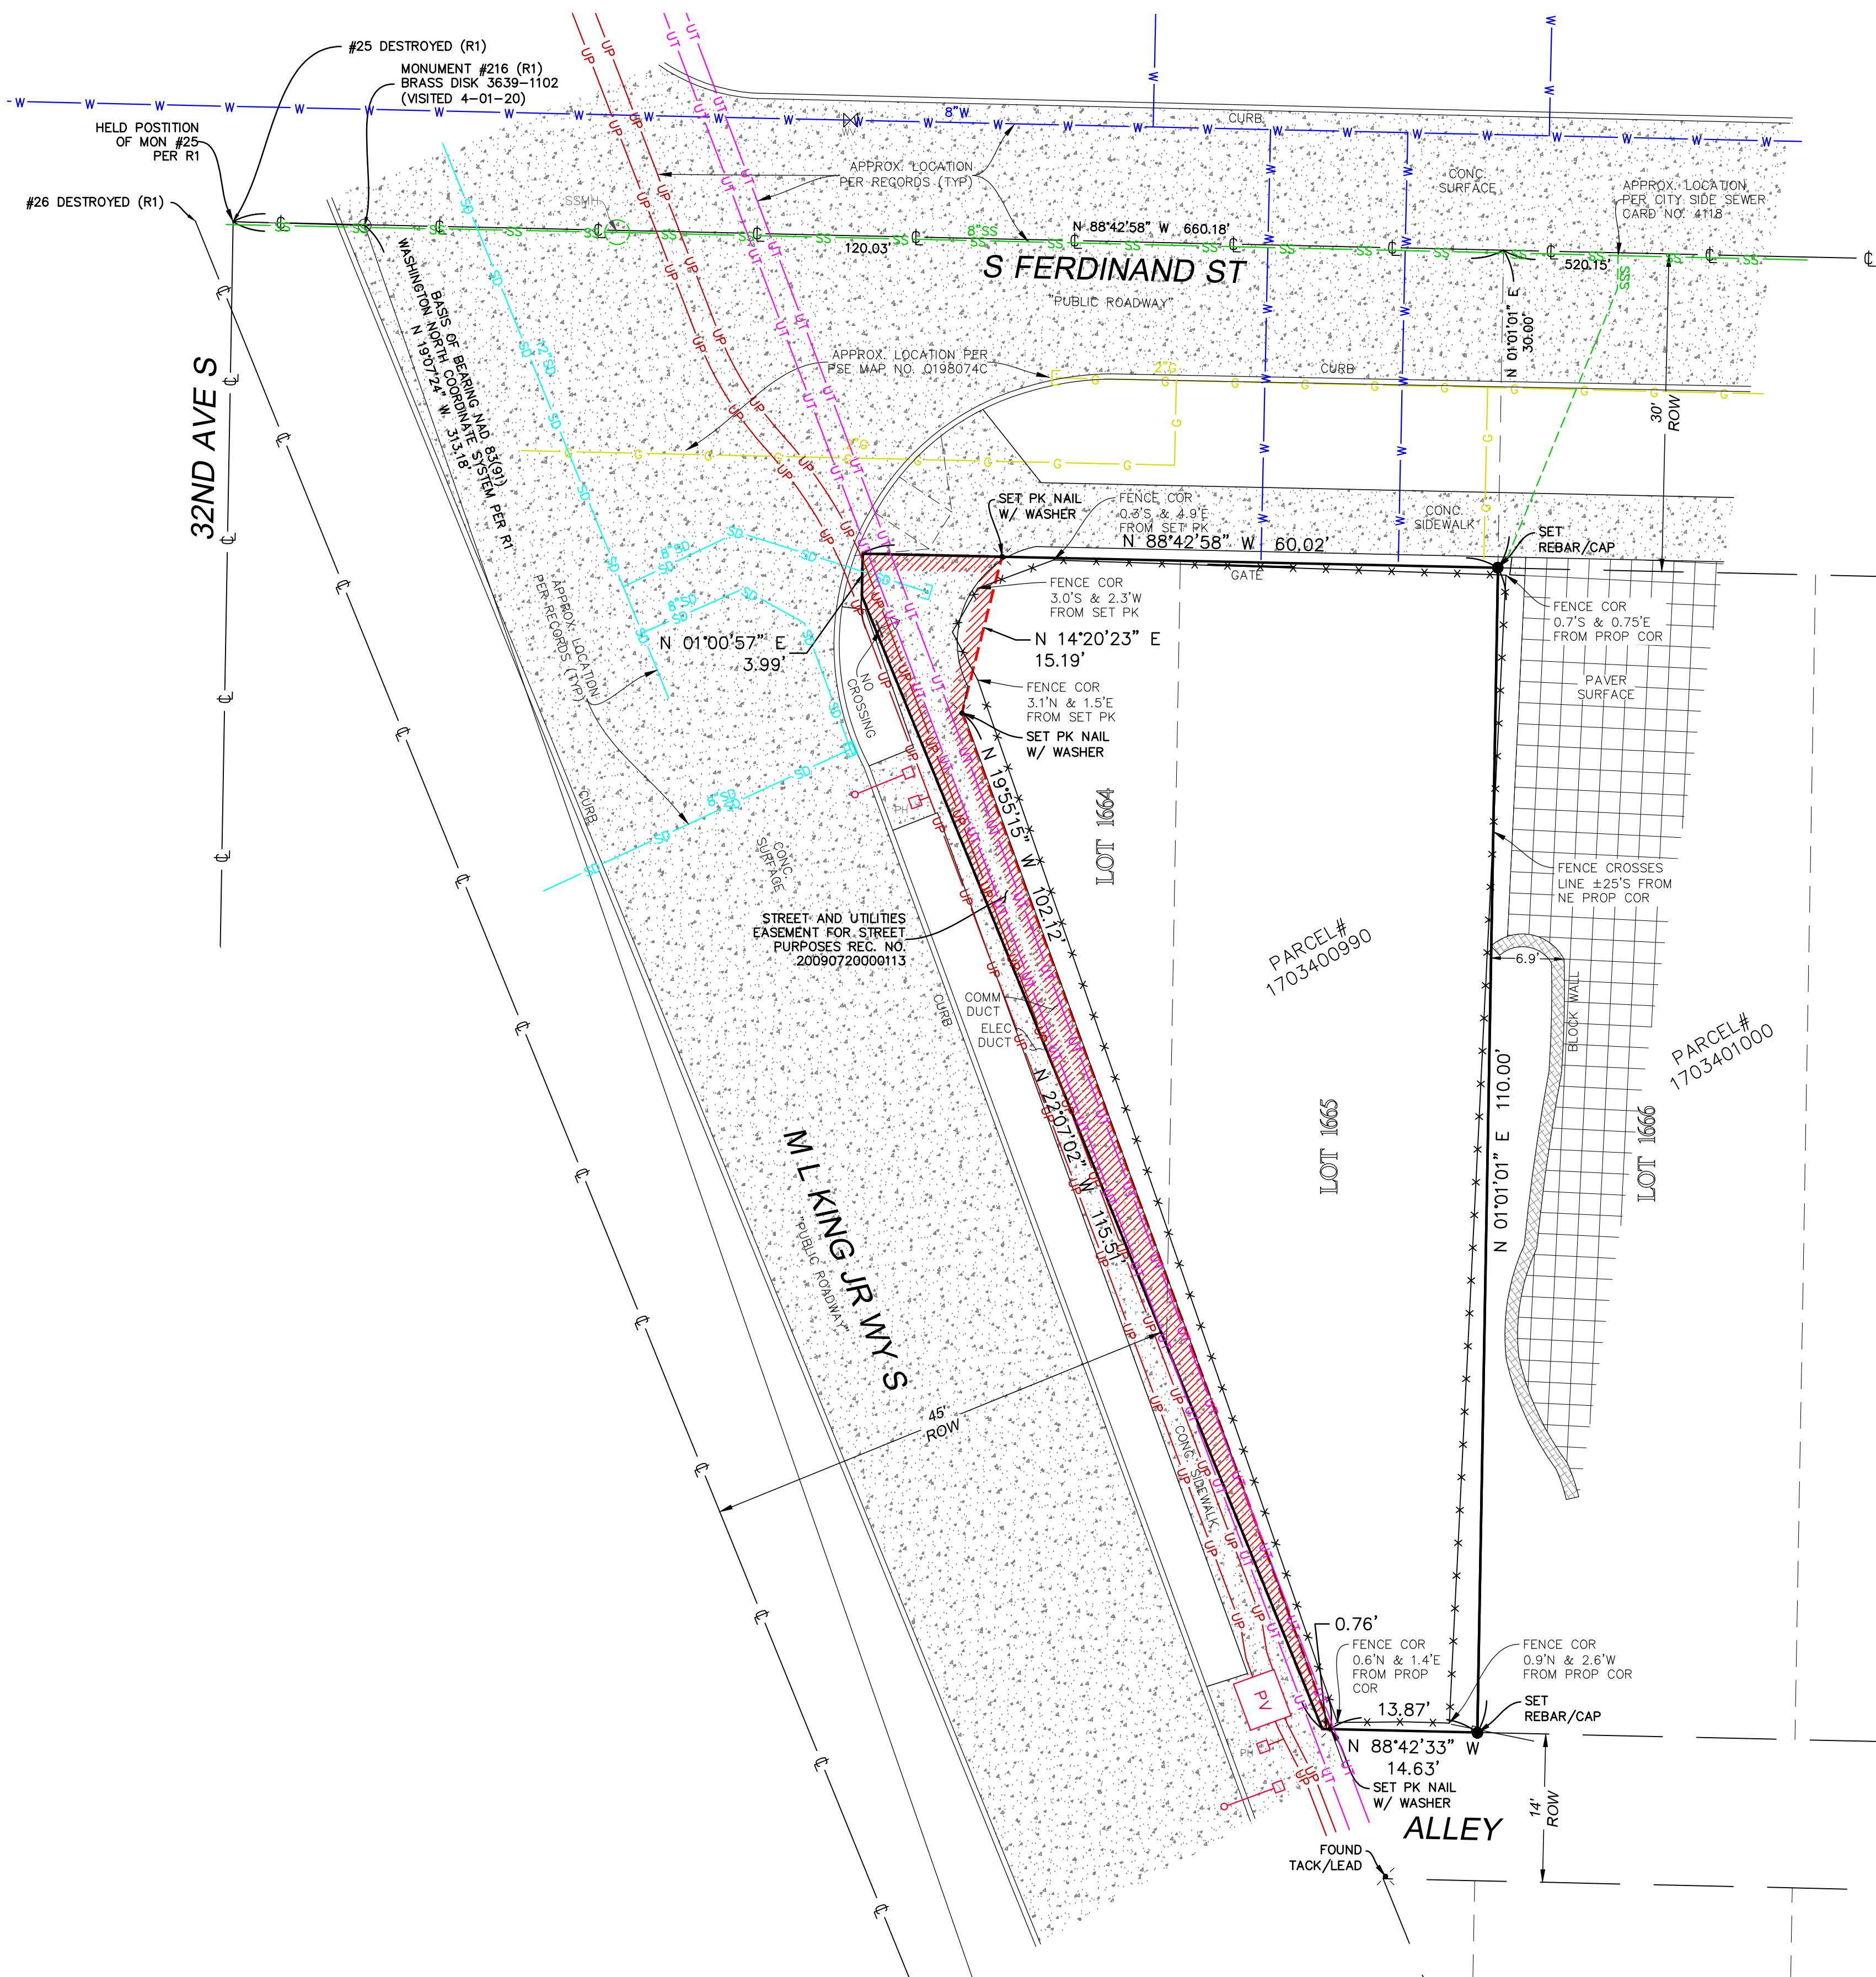

THE TYPES AND LOCATIONS OF ANY UTILITIES SHOWN ON THIS DRAWING ARE BASED ON INFORMATION PROVIDED TO US, BY OTHERS OR GENERAL INFORMATION READILY AVAILABLE IN THE PUBLIC DOMAIN INCLUDING, AS APPLICABLE, IDENTIFYING MARKINGS PLACED BY UTILITY LOCATE SERVICES AND OBSERVED BY TERRANE IN THE FIELD. AS SUCH, THE UTILITY INFORMATION SHOWN ON THESE DRAWINGS ARE FOR INFORMATIONAL PURPOSES ONLY AND SHOULD NOT BE RELIED ON FOR DESIGN OR CONSTRUCTION PURPOSES; TERRANE IS NOT RESPONSIBLE OR LIABLE FOR THE ACCURACY OR COMPLETENESS OF THIS UTILITY INFORMATION. FOR THE ACCURATE LOCATION AND TYPE OF UTILITIES NECESSARY FOR DESIGN AND CONSTRUCTION, PLEASE CONTACT THE SITE OWNER AND THE LOCAL UTILITY LOCATE SERVICE (800-424-5555).

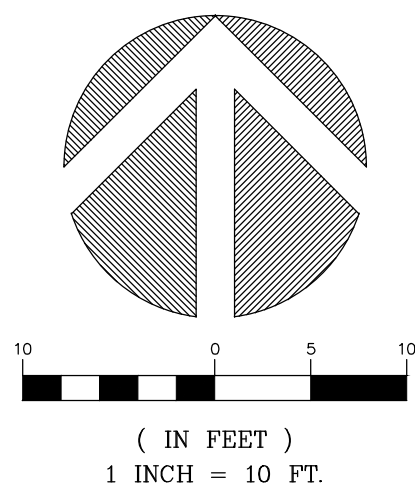

ALTANSPS LAND TITLE SURVEY

TAX PARCEL NO. 1703400990

Seattle Office of Housing - Site 10

3201 S Ferdinand St
SEATTLE, WA 98118



Terrane
10801 Main Street, Suite 102, Bellevue, WA 98004
phone 425.458.4488 support@terrane.net
www.terrane.net

JOB NUMBER:	210407
DATE:	06/18/21
DRAFTED BY:	JKK
CHECKED BY:	SRM
SCALE:	1" = 10'
REVISION HISTORY	
SHEET NUMBER	2 OF 2

measure success